

These data are provided on an "AS-IS" basis, without warranty of any type, expressed or implied, including but not limited to any warranty as to their performance, merchantability, or fitness for any particular purpose.

1:11,015

Date: 7/22/2021

This map is not a substitute for accurate field surveys or for locating actual property lines and any adjacent features.



PLANS IMPROVEMENT A COUNTY DITCH NO. 14 CHIPPEWA COUNTY, MINNESOTA

INDEX



SHEET NO. 1	PLAT, INDEX & ESTIMATED QUANTITIES.
SHEET NO. 2	PROFILE OF MAIN & BRANCHES 1, 2, 3, 4, 5, 6, 7, 9, A, A1, A2, A3, A4, A5, X & Y.
SHEET NO. 3	DETAILS OF OPEN DITCH, OUTLET PIPE & TILE INLETS.

ESTIMATED QUANTITIES

OPEN DITCH						
BRANCH	STA.	TO	STA.	LENGTH	BOTTOM	CUBIC YARDS
MAIN	0		52+01	5,201'	4'	34,955

CULVERTS				HIGHWAY CULVERTS			
NUMBER	TOTAL LENGTH	SIZE	TYPE	NUMBER	TOTAL LENGTH	SIZE	TYPE
1	40'	48"	S.C.	1	56'	48"	S.C.
5	150'	12"	GMP				

OUTLETS				TILE WORK			
NUMBER	TOTAL LENGTH	SIZE	TYPE	SIZE	LENGTH	AVE. DEPTH	INLETS
1	20'	21"	CM16	18"	1,088'	6.9'	10"-2
2	40'	15"	CM16	14"	1,928'	5.3'	8"-1
2	40'	12"	CM16	12"	2,770'	5.9'	6"-31
2	40'	10"	CM16	10"	3,772'	4.7'	
				8"	9,771'	4.3'	
				TOTAL	19,329'		

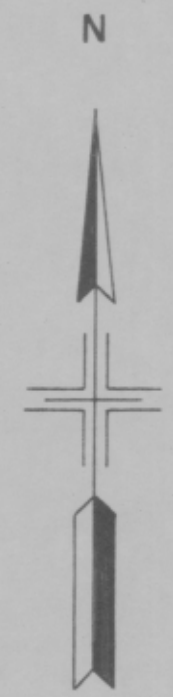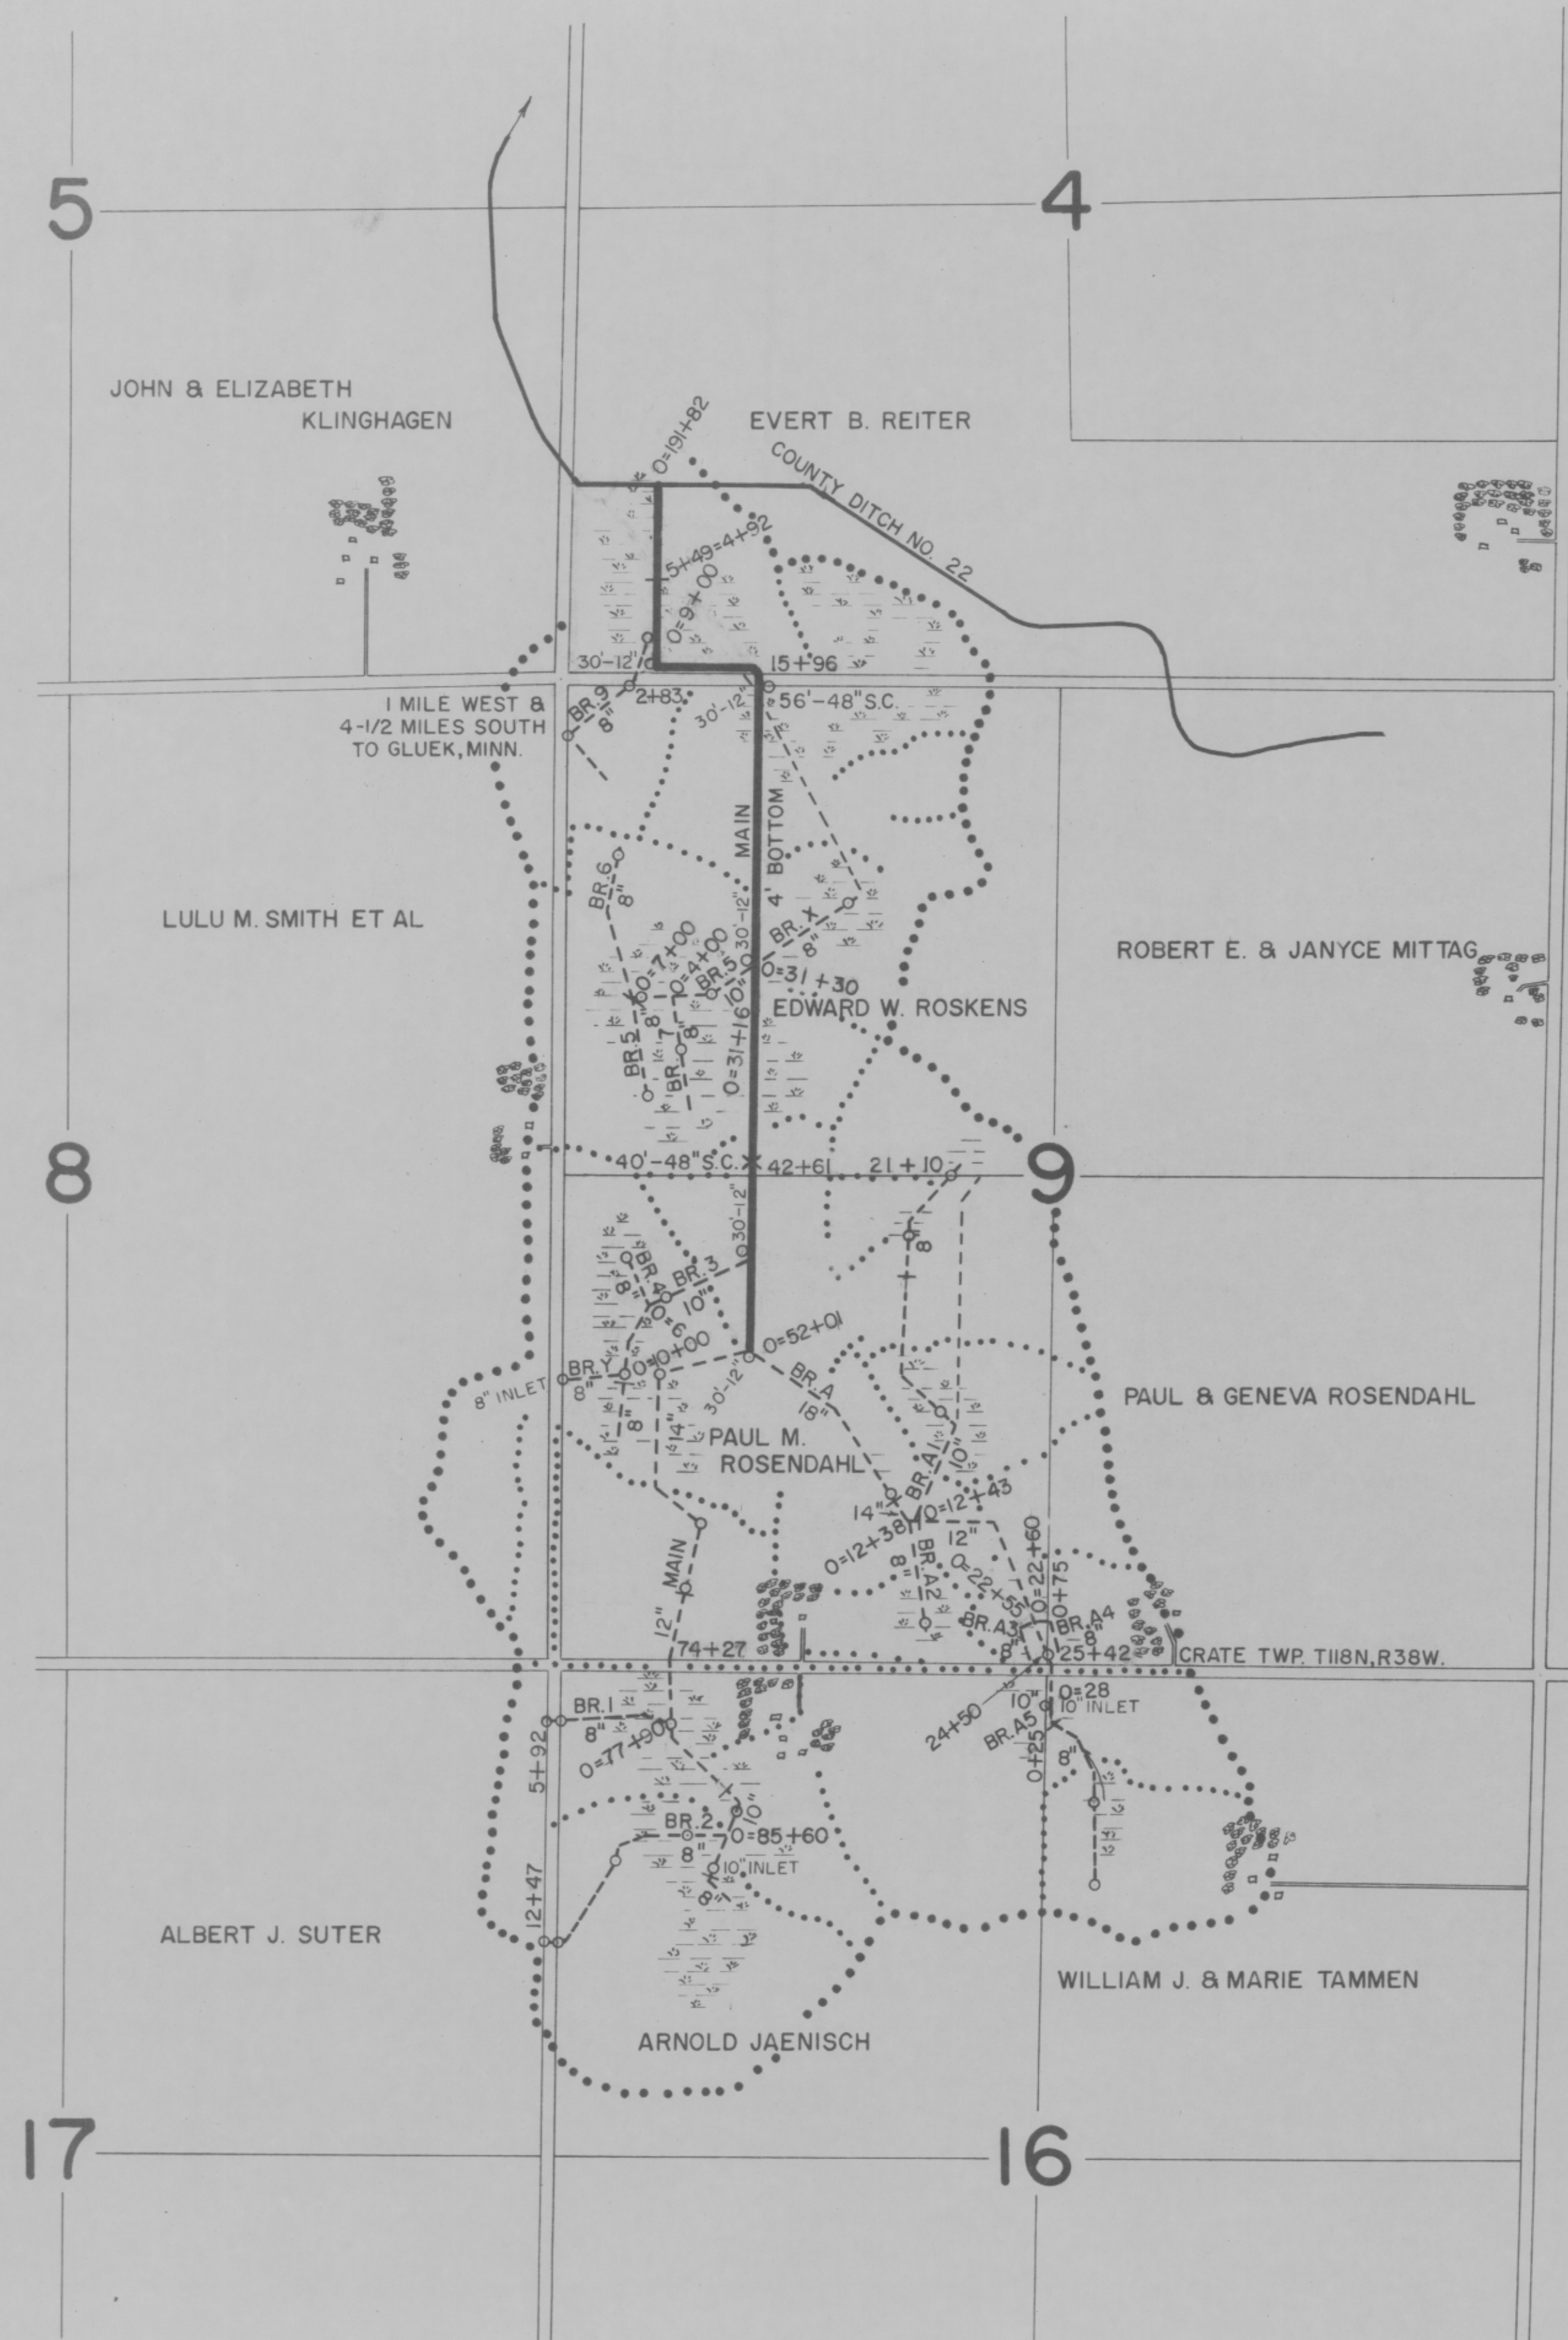

TED L. CHAMBERLAIN, ENGINEER, MONTEVIDEO & OLIVIA, MINNESOTA			
MAPPING	C. G. 10-69	DESIGN	G. S. 5-71
PRELIM. SURVEY	V. S. 2-70	DRAFTING	K. N. 6-71
DESIGN	G. S. 2-70	REVISED	
DRAFTING	W. H. 3-70	CONST. SURVEY	L. T. 8-72
FINAL SURVEY	L. T. 5-71	CORRECTED PLAN	S. O. 12-82
Date Jan. 21, 1983, Rev. No. 8808 PLANS CORRECTED TO SHOW DITCH AS CONSTRUCTED			

IMPROVEMENT A OF COUNTY DITCH NO. 14
CHIPPEWA COUNTY MINNESOTA